


# BWC BUCKMASTER POND, LLC DOVER LANDFILL SOLAR DEVELOPMENT PROJECT POWISSET STREET, DOVER, MASSACHUSETTS

UPDATED SITE PLANS WITH HIGHLIGHTED CHANGES

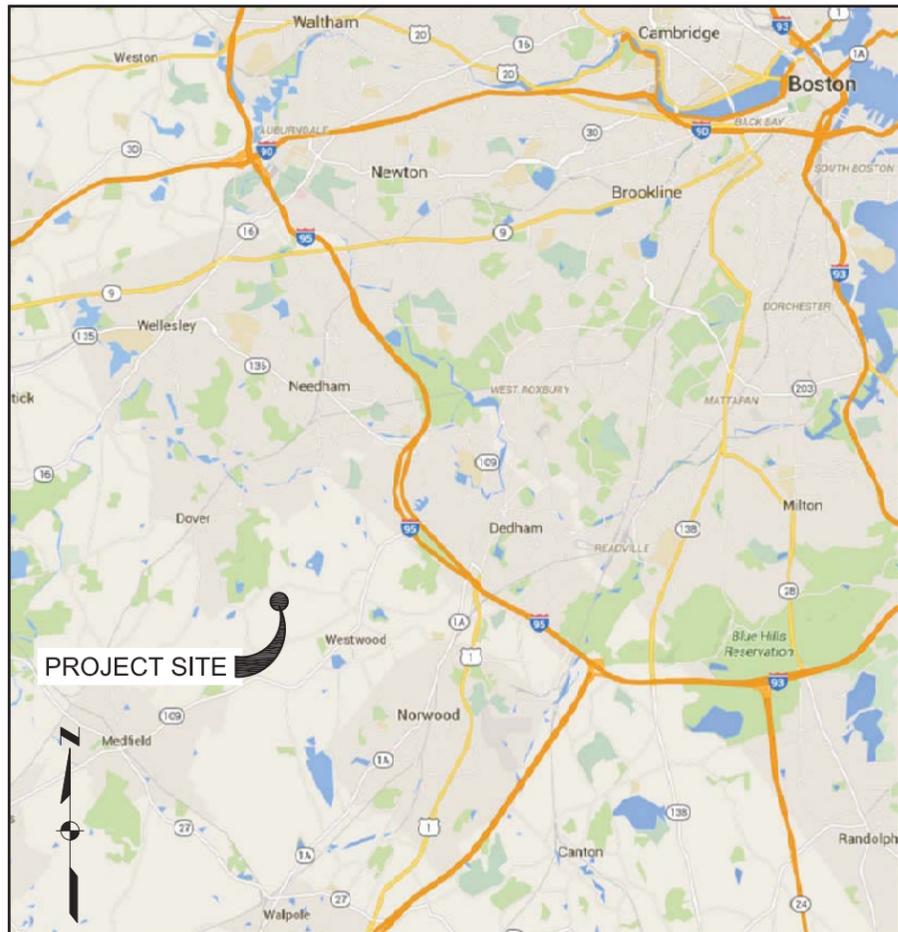

**VICINITY MAP**  
NOT TO SCALE



**LOCUS MAP**  
1" = 800'

**SHEET INDEX**

- C1 COVER SHEET
- C2 EXISTING CONDITIONS
- C3 SITE DEVELOPMENT PLAN
- C4 DETAILS SHEET 1
- C5 DETAILS SHEET 2
- C6 DETAILS SHEET 3
- C7 EROSION AND SEDIMENT CONTROL PLAN
- C8 ENVIRONMENTAL MONITORING PLAN

**PROJECT APPLICANT**

BWC BUCKMASTER POND, LLC  
137 NEWBURY STREET, 4TH FLOOR  
BOSTON, MA 02116

PHONE: (617) 209-3122  
ATTN: JON MANCINI

**PROPERTY OWNER**

HALE RESERVATION TRUST  
80 CARBY STREET  
WESTWOOD, MA 02040

PHONE: (781) 326-1770  
ATTN: ERIC ARNOLD

**PV SYSTEM INSTALLER**

BLUEWAVE CAPITAL, LLC  
137 NEWBURY STREET  
BOSTON, MA 02116

PHONE: (617) 209-3122  
ATTN: JON MANCINI

**PROJECT ENGINEER**

KENNEDY/JENKS CONSULTANTS  
ONE HIGHWOOD DRIVE, SUITE 301  
TEWKSBURY, MA 01876

PHONE: (978) 770-2031  
ATTN: MICHAEL CLARK, P.E.

FOR PERMITTING ONLY

**Kennedy/Jenks  
Consultants.**

TEWKSBURY, MA

USE OF DOCUMENTS:  
THIS DOCUMENT, INCLUDING THE INCORPORATED DESIGNS, IS AN INSTRUMENT OF SERVICE FOR THIS PROJECT AND SHALL NOT BE USED FOR ANY OTHER PROJECT WITHOUT THE WRITTEN AUTHORIZATION OF KENNEDY/JENKS CONSULTANTS.

NO.	REVISION	DATE	BY
2	REVISED FOR PLANNING BOARD	19 JULY 2016	AEW
1	ISSUED FOR PERMITTING	23 JUN 2016	BRK

**SCALES**  
0 1" = 800'  
0 25mm



IF THIS BAR IS NOT DIMENSION SHOWN, ADJUST SCALES ACCORDINGLY.



DESIGNED	J. SMITH
DRAWN	B. KIELY
CHECKED	M. CLARK

<b>COVER SHEET</b>
BWC BUCKMASTER POND, LLC BOSTON, MA
<b>DOVER LANDFILL SOLAR DEVELOPMENT PROJECT</b>


FILE NAME	1642009_COVER
JOB NO.	1642009*00
DATE	20 JULY 2016
SHEET	<b>C1</b>
OF	8

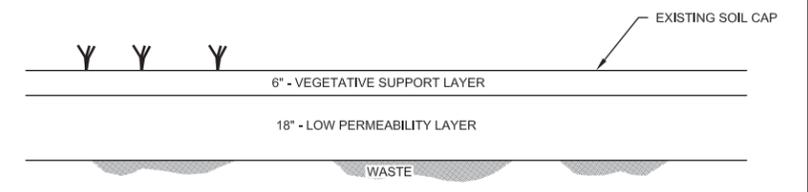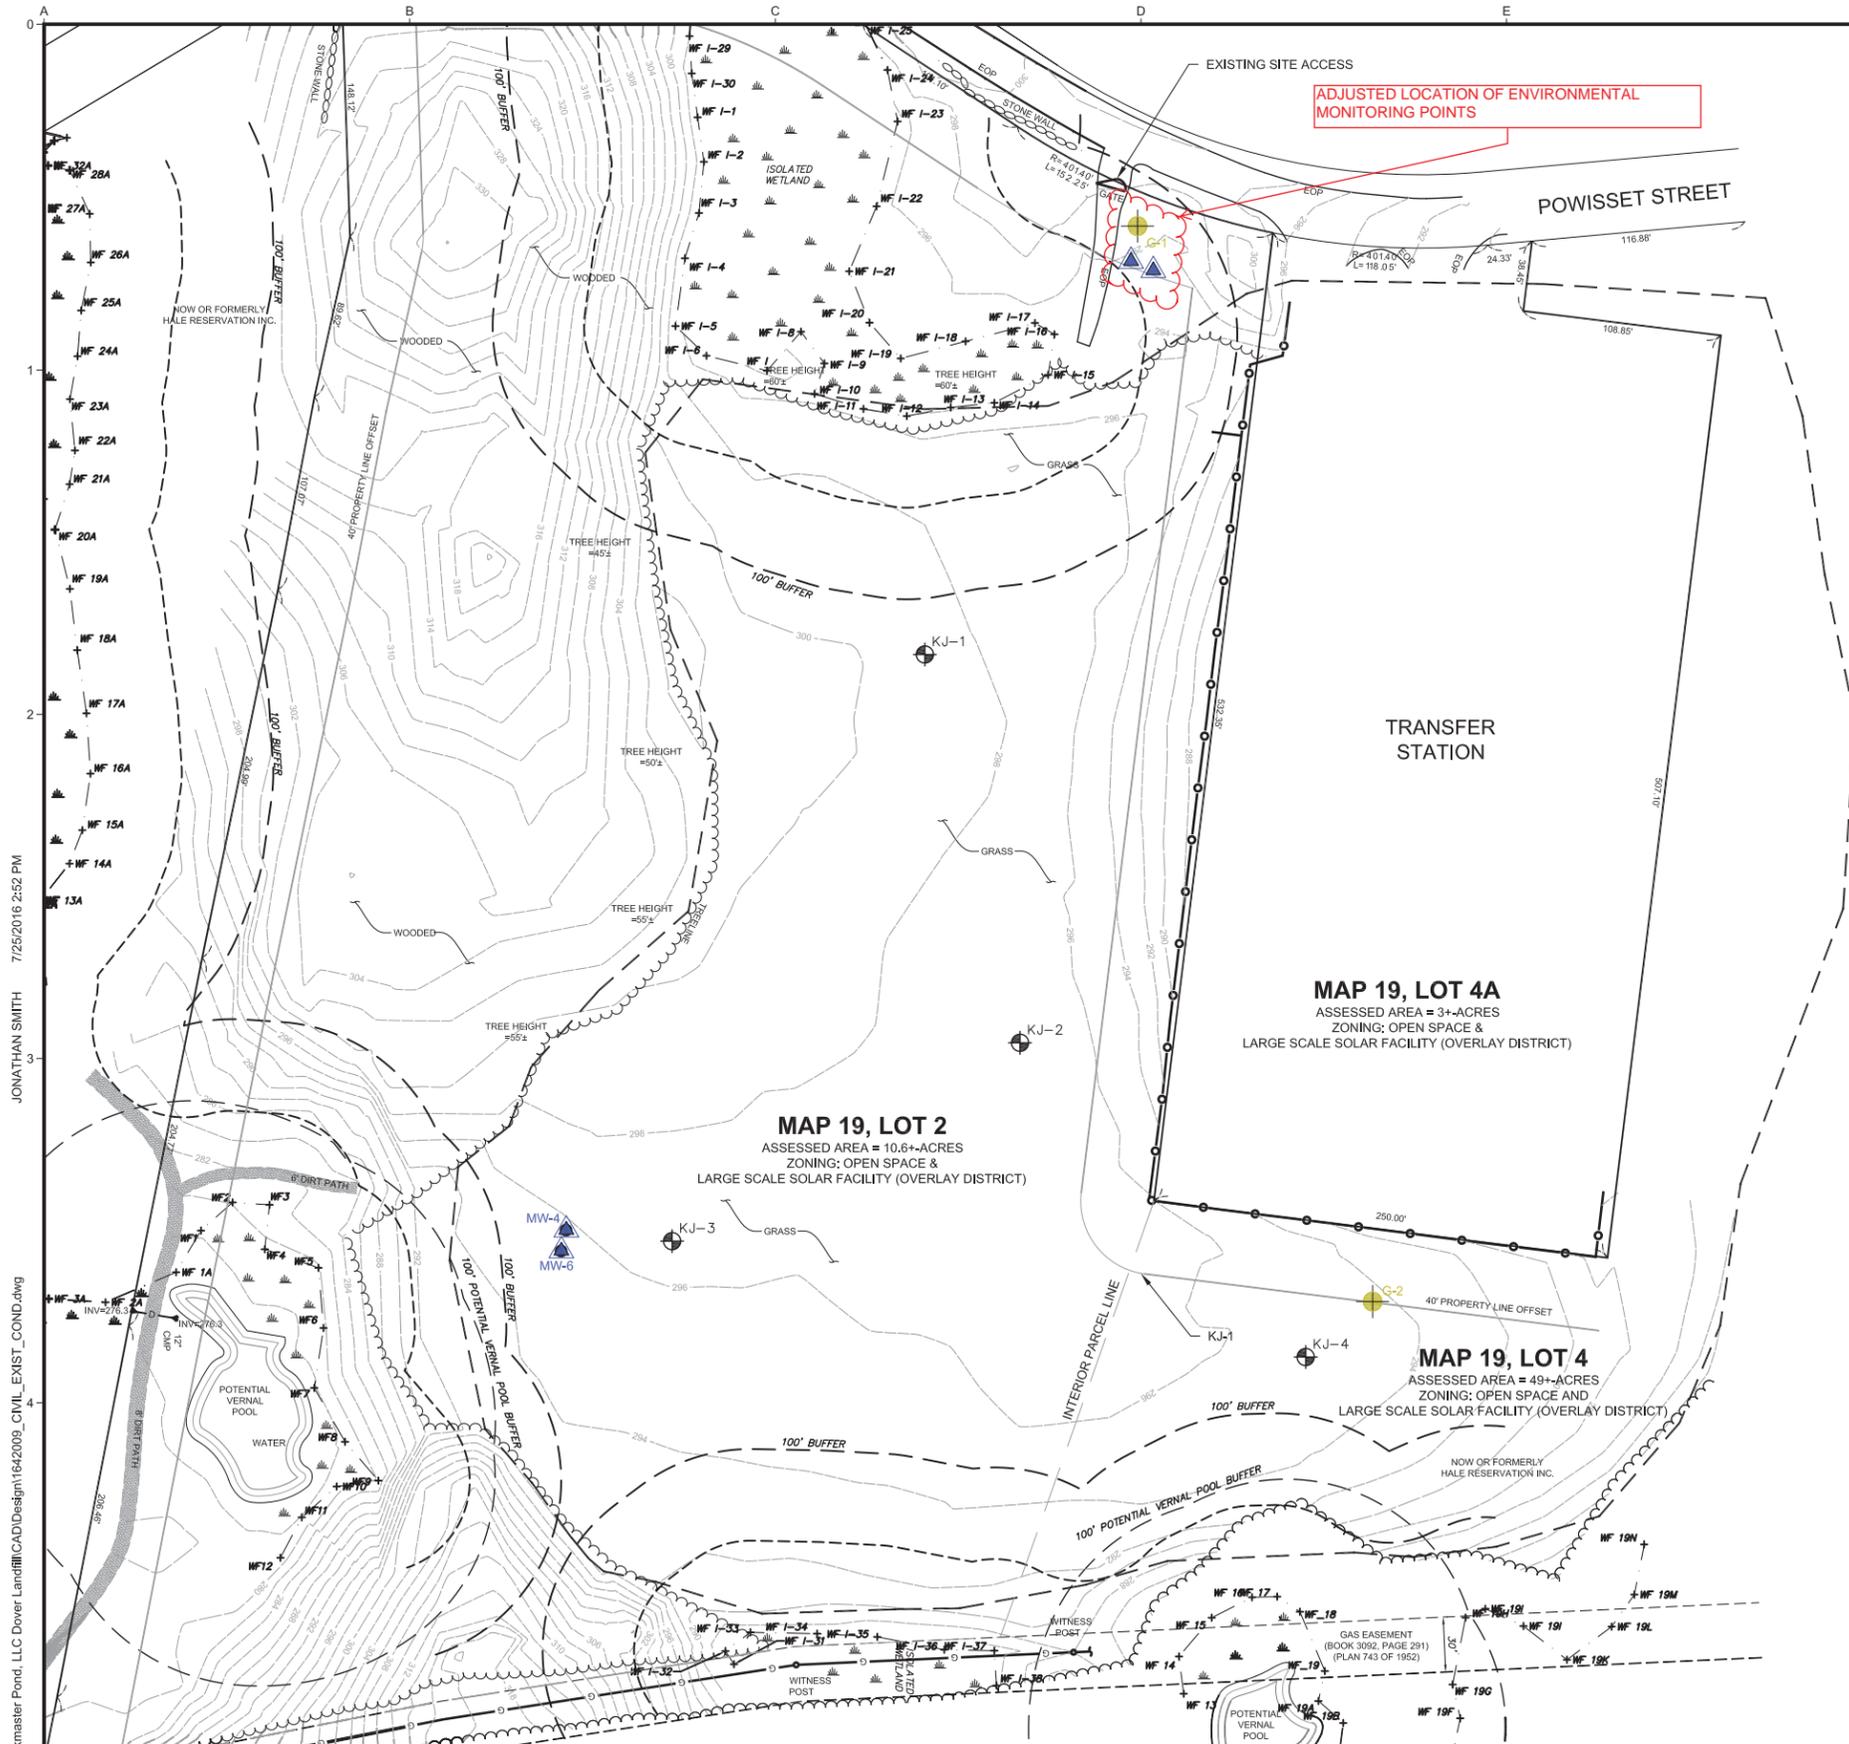

**LEGEND**

WF 1-20	WETLANDS FLAG
Wetlands symbol	WETLANDS SYMBOL
--- (dashed)	WETLANDS BOUNDARY
--- (long dashed)	50' WETLANDS BUFFER
--- (short dashed)	100' WETLANDS BUFFER
--- (solid)	LIMIT OF LANDFILL CAP
--- (dotted)	PROPERTY BOUNDARY
--- (wavy)	STONE WALL
--- (dashed with dots)	MAJOR ELEVATION CONTOUR (10' INTERVALS)
--- (dashed with dots)	MINOR ELEVATION CONTOUR (2' INTERVALS)
--- (dashed with circles)	EXISTING CHAIN LINK FENCE
--- (dashed with triangles)	EXISTING TREE LINE
--- (dashed with G's)	EXISTING UNDERGROUND GAS LINE
EOP	EDGE OF PAVEMENT
INV	INVERT ELEVATION
CMP	CORRUGATED METAL PIPE
G-2	GAS MONITORING WELL
MW-2	SURFACE SOIL SAMPLING POINT
Triangle symbol	MONITORING WELL LOCATION

- NOTES**
- THE TOPOGRAPHY, SITE DETAIL & SURFACE IMPROVEMENTS DEPICTED HEREON WERE OBTAINED FROM AN ON THE GROUND INSTRUMENT SURVEY CONDUCTED BY MERIDIAN ASSOCIATES, INC. (MAI) BETWEEN APRIL 19-26, 2016.
  - THE LOCATION OF ALL UNDERGROUND UTILITIES SHOWN ARE APPROXIMATE AND ARE BASED UPON A PARTIAL FIELD SURVEY. MERIDIAN ASSOCIATES, INC. DOES NOT WARRANT NOR GUARANTEE THE LOCATION OF ALL UTILITIES DEPICTED OR NOT DEPICTED. THE CONTRACTOR, PRIOR TO COMMENCEMENT OF CONSTRUCTION, SHALL VERIFY THE LOCATION OF ALL UTILITIES AND CONTACT DIG SAFE AT 1-888-344-7233.
  - THIS PLAN DOES NOT SHOW ANY UNRECORDED OR UNWRITTEN EASEMENTS WHICH MAY EXIST. A REASONABLE AND DILIGENT ATTEMPT HAS BEEN MADE TO OBSERVE ANY APPARENT, VISIBLE USES OF THE LAND; HOWEVER, THIS DOES NOT CONSTITUTE A GUARANTEE THAT NO SUCH EASEMENTS EXIST.
  - THE ELEVATIONS DEPICTED HEREON WERE BASED ON THE NORTH AMERICAN VERTICAL DATUM OF 1988 (NAVD 88), AS DERIVED FROM GPS OBSERVATIONS.
  - THE WETLAND FLAGS DEPICTED WERE DEMARCATED BY LEC ENVIRONMENTAL CONSULTANTS, INC. ON APRIL 18, 2016.
  - PROPERTY LINES DEPICTED HEREON ARE BASED ON COMPILED DEEDS AND PLANS OF RECORD.

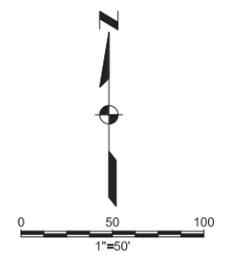

**FOR PERMITTING ONLY**

JONATHAN SMITH 7/25/2016 2:52 PM  
 P:\2016\1642009.00 - BWC Buckmaster Pond, LLC Dover Landfill\CAD\Design\1642009\_CIVIL\_EXIST\_COND.dwg

**Kennedy/Jenks Consultants.**  
 TEWKSBURY, MA

USE OF DOCUMENTS:  
 THIS DOCUMENT, INCLUDING THE INCORPORATED DESIGNS, IS AN INSTRUMENT OF SERVICE FOR THIS PROJECT AND SHALL NOT BE USED FOR ANY OTHER PROJECT WITHOUT THE WRITTEN AUTHORIZATION OF KENNEDY/JENKS CONSULTANTS.


NO.	REVISION	DATE	BY
1	ISSUED FOR PERMITTING	23 JUN 2016	BRK

**SCALES**

0 1" = 100'

0 25mm

IF THIS BAR IS NOT DIMENSION SHOWN, ADJUST SCALES ACCORDINGLY.




DESIGNED	J. SMITH
DRAWN	B. KIELY
CHECKED	M. CLARK

**EXISTING CONDITIONS**

BWC BUCKMASTER POND, LLC  
 BOSTON, MA

**DOVER LANDFILL SOLAR DEVELOPMENT PROJECT**


FILE NAME	1642009_CIVIL
JOB NO.	1642009'00
DATE	20 JULY 2016
SHEET OF	C2 OF 8

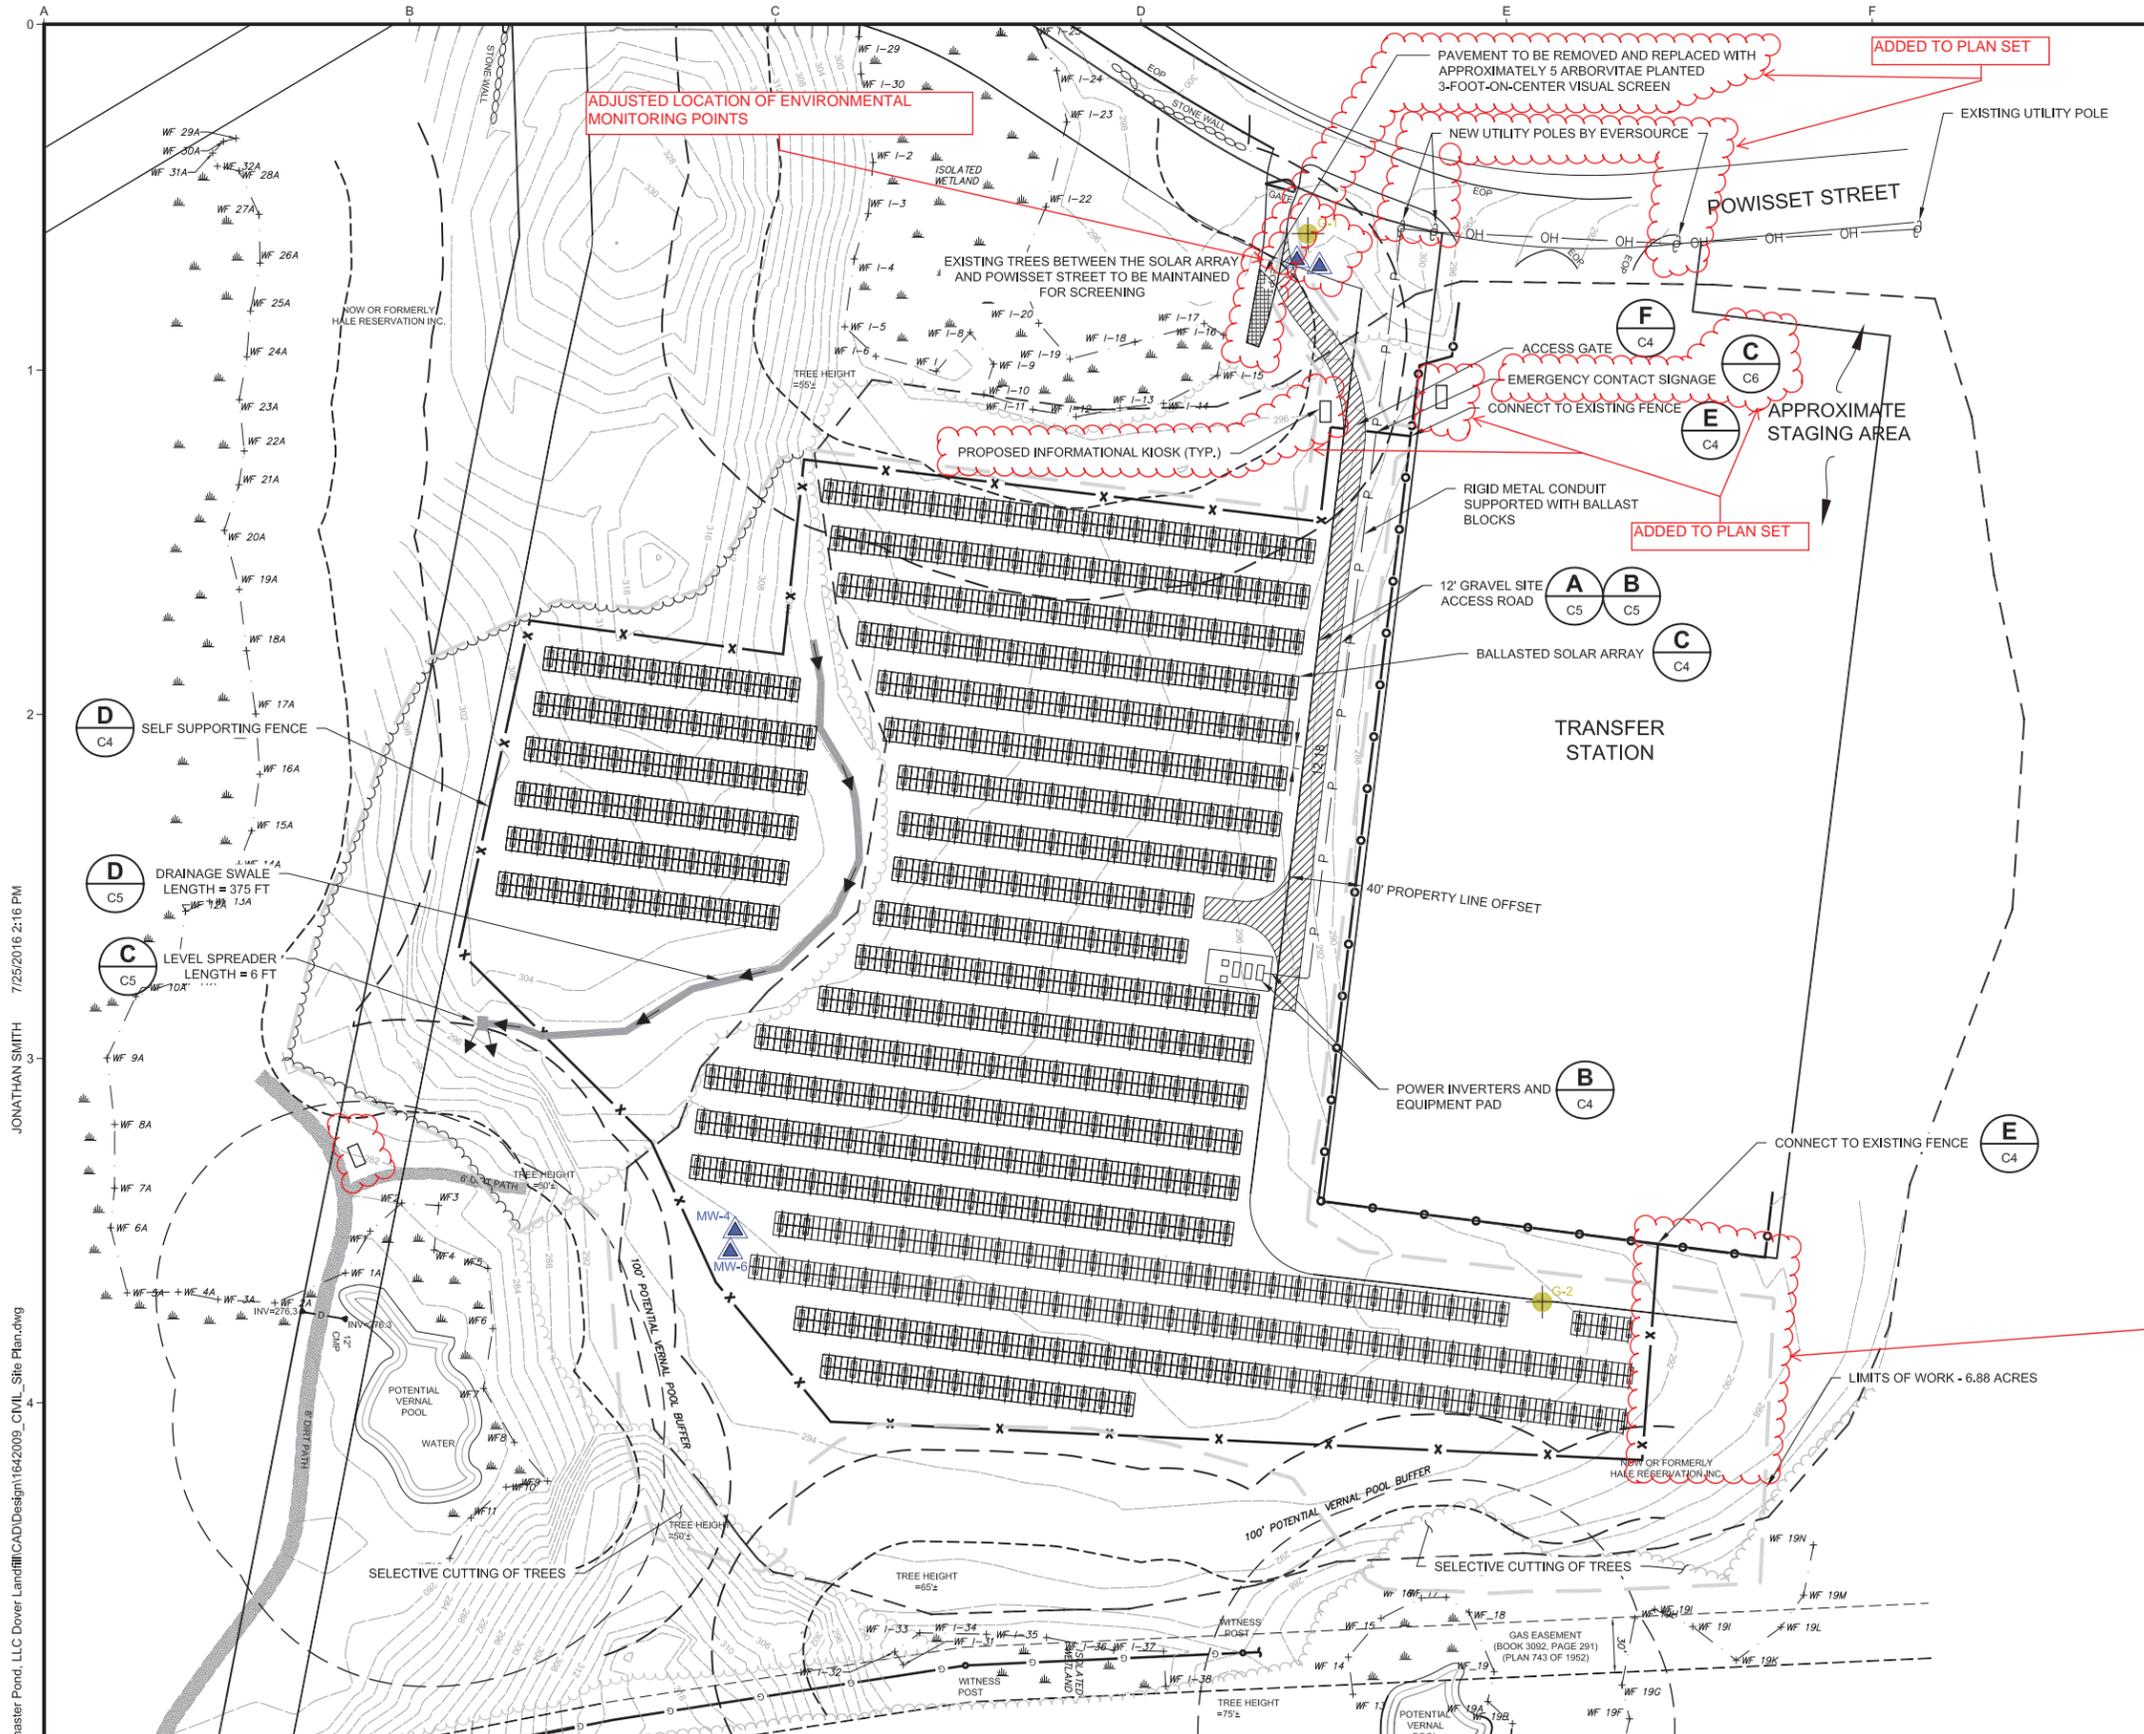

**LEGEND**

	WETLANDS FLAG
	WETLANDS SYMBOL
	WETLANDS BOUNDARY
	50' WETLANDS BUFFER
	100' WETLANDS BUFFER
	LIMIT OF LANDFILL CAP
	PROPERTY BOUNDARY
	STONE WALL
	MAJOR ELEVATION CONTOUR (10' INTERVALS)
	MINOR ELEVATION CONTOUR (2' INTERVALS)
	EXISTING CHAIN LINK FENCE
	EXISTING TREE LINE
	PROPOSED TREE LINE
	EXISTING UNDERGROUND GAS LINE
	OVERHEAD POWER LINE
	ELECTRICAL CONDUIT
	UTILITY POLE
	EDGE OF PAVEMENT
	INVERT ELEVATION
	CORRUGATED METAL PIPE
	DIRECTION OF STORMWATER FLOW
	GAS MONITORING WELL
	MONITORING WELL LOCATION
	PROPOSED INFORMATIONAL KIOSK LOCATION

EQUIPMENT	SPECIFICATION	QUANTITY
PV MODULES	~320W OR EQUIVALENT	3,542
PV TABLES	RBI RACKING SYSTEM	400
PV INVERTER/TRANSFORMER	SMA STRING INVERTERS OR EQUIVALENT	TBD

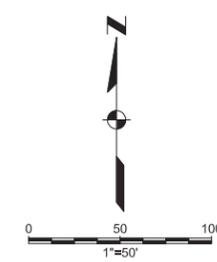

**FOR PERMITTING ONLY**



JONATHAN SMITH 7/25/2016 2:16 PM  
 P:\2016\1642009.00 - BWC Buckmaster Pond, LLC Dover Landfill\CAD\Design\1642009\_CIVIL\_Site Plan.dwg

**Kennedy/Jenks Consultants**  
 TEWKSBURY, MA

USE OF DOCUMENTS:  
 THIS DOCUMENT, INCLUDING THE INCORPORATED DESIGNS, IS AN INSTRUMENT OF SERVICE FOR THIS PROJECT AND SHALL NOT BE USED FOR ANY OTHER PROJECT WITHOUT THE WRITTEN AUTHORIZATION OF KENNEDY/JENKS CONSULTANTS, LLC.

NO.	REVISION	DATE	BY
1	ISSUED FOR PERMITTING	23 JUN 2016	BRK

NO.	REVISION	DATE	BY
1	ISSUED FOR PERMITTING	23 JUN 2016	BRK

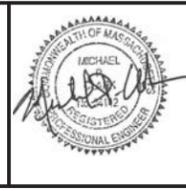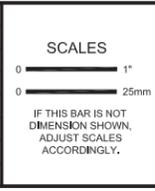

DESIGNED	J. SMITH
DRAWN	B. KIELY
CHECKED	M. CLARK


**SITE DEVELOPMENT PLAN**

BWC BUCKMASTER POND, LLC  
 BOSTON, MA

**DOVER LANDFILL SOLAR DEVELOPMENT PROJECT**


FILE NAME	1642009_CIVIL_Site Plan
JOB NO.	1642009'00
DATE	20 JULY 2016
SHEET	OF
<b>C3</b>	8



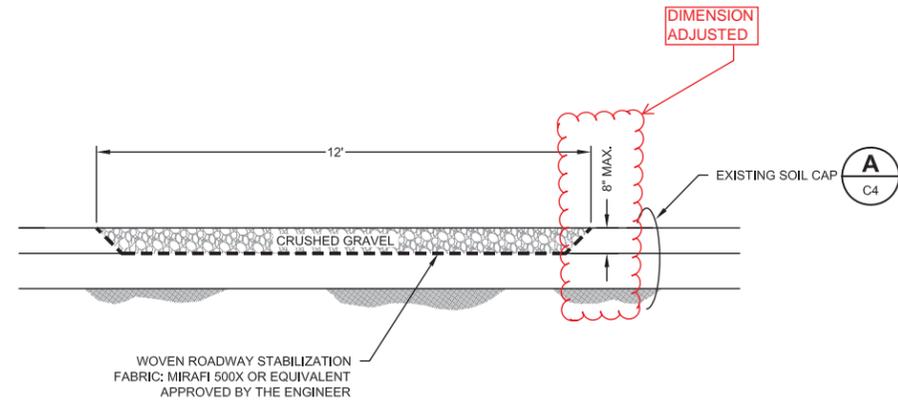


- NOTES:
1. PROPOSED GRAVEL ROAD TO BE FLUSH WITH UPGRADIENT EXISTING GROUND SURFACE TO PROMOTE CONTINUED SHEET FLOW OF STORMWATER RUNOFF.
  2. MINIMUM 1% SLOPE TO BE MAINTAINED ACROSS ROAD. MAXIMUM CROSS ROAD SLOPE TO BE 5%.

**ROAD SECTION DETAIL A**  
NOT TO SCALE

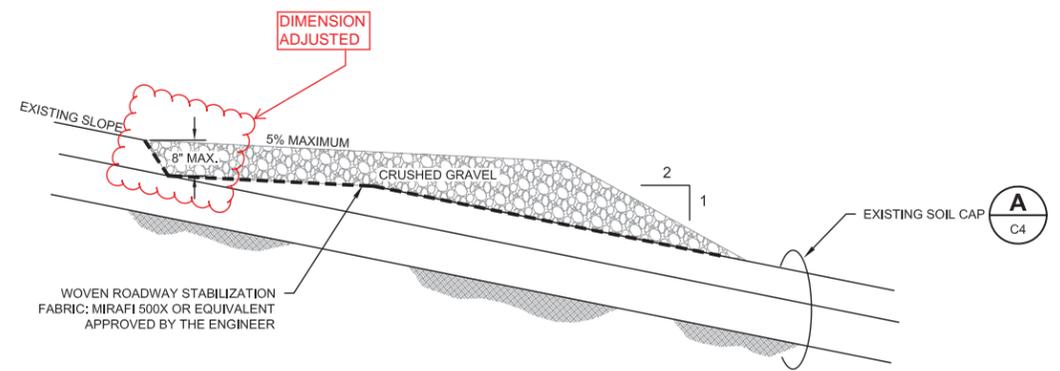


- NOTES:
1. PROPOSED GRAVEL ROAD TO BE FLUSH WITH UPGRADIENT EXISTING GROUND SURFACE TO PROMOTE CONTINUED SHEET FLOW OF STORMWATER RUNOFF.
  2. MINIMUM 1% SLOPE TO BE MAINTAINED ACROSS ROAD. MAXIMUM 5% SLOPE TO BE MAINTAINED WHERE EXISTING SLOPE EXCEEDS 5%.

**SLOPED ROAD SECTION DETAIL B**  
NOT TO SCALE

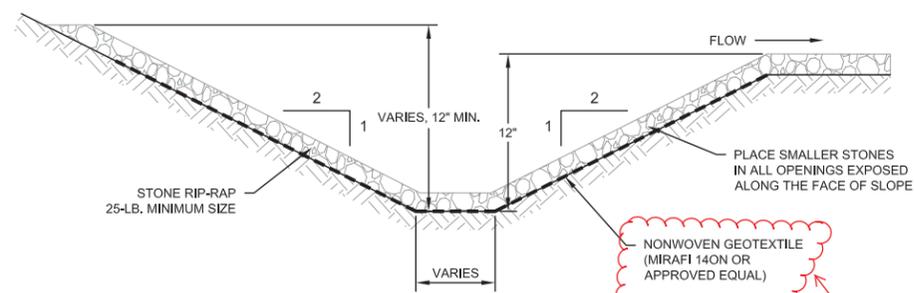

**RIP RAP LEVEL SPREADER C**  
NOT TO SCALE

GEOTEXTILE TYPE SPECIFIED

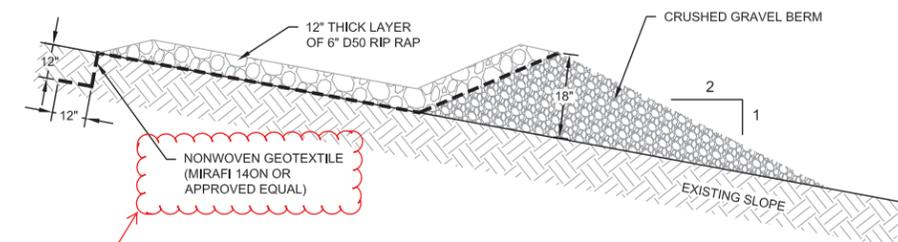

**STORMWATER SWALE D**  
NOT TO SCALE

GEOTEXTILE TYPE SPECIFIED

FOR PERMITTING ONLY

**Kennedy/Jenks Consultants**  
TEWKSBURY, MA

USE OF DOCUMENTS:  
THIS DOCUMENT, INCLUDING THE INCORPORATED DESIGNS, IS AN INSTRUMENT OF SERVICE FOR THIS PROJECT AND SHALL NOT BE USED FOR ANY OTHER PROJECT WITHOUT THE WRITTEN AUTHORIZATION OF KENNEDY/JENKS CONSULTANTS.

NO.	REVISION	DATE	BY
1	ISSUED FOR PERMITTING	23 JUN 2016	BRK

SCALES  
0 = 1"  
0 = 25mm  
IF THIS BAR IS NOT DIMENSION SHOWN, ADJUST SCALES ACCORDINGLY.



DESIGNED: J. SMITH  
DRAWN: B. KIELY  
CHECKED: M. CLARK

**DETAILS SHEET 2**  
BWC BUCKMASTER POND, LLC  
BOSTON, MA  
**DOVER LANDFILL SOLAR DEVELOPMENT PROJECT**

FILE NAME: 1642009\_CIVIL\_Details  
JOB NO.: 1642009\*00  
DATE: 20 JULY 2016  
SHEET OF: **C5** OF 8

**EROSION AND SEDIMENT CONTROL NOTES**

- ALL EROSION AND SEDIMENTATION CONTROL MEASURES SHALL BE CONSTRUCTED IN ACCORDANCE WITH THE MASSACHUSETTS EROSION AND SEDIMENTATION CONTROL GUIDELINES FOR URBAN AND SUBURBAN AREAS DATED MARCH 1997, THE U.S.D.A. S.C.S. EROSION AND SEDIMENT CONTROL IN SITE DEVELOPMENT, MASSACHUSETTS CONSERVATION GUIDE, DATED SEPTEMBER 1983 AND ALL LOCAL MUNICIPAL REGULATIONS.
- EROSION AND SEDIMENTATION CONTROL MEASURES SHALL BE IN PLACE PRIOR TO THE COMMENCEMENT OF ANY SITE WORK OR EARTHWORK OPERATIONS, AND SHALL REMAIN IN PLACE UNTIL ALL SITE WORK IS COMPLETE AND PERMANENT GROUND COVER IS ESTABLISHED.
- A QUALIFIED ENGINEER WILL OVERSEE CONSTRUCTION ACTIVITIES TO ENSURE THAT MEANS AND METHODS COMPLY WITH APPLICABLE PERMITS AND MGL SOLID WASTE REGULATIONS.
- ONLY LOW-GROUND PRESSURE EQUIPMENT (7 PSI MAX.) SHALL BE USED WITHIN THE LIMITS OF THE LANDFILL COVER SYSTEM.
- EACH DAY, GROUND CONDITIONS MUST BE INSPECTED PRIOR TO COMMENCING WORK ACTIVITIES WITHIN THE LIMITS OF THE LANDFILL COVER SYSTEM. NO WORK MAY BE CONDUCTED DURING WET WEATHER THAT COULD LEAD TO RUTTING OR EROSION OF THE LANDFILL COVER SYSTEM.
- CONSTRUCTION ACTIVITIES MUST BE CEASED IN AREAS WITHIN THE LANDFILL COVER SYSTEM THAT ARE DEMONSTRATING GREATER THAN 1" OF RUTTING UNTIL THOSE AREAS ARE STABILIZED AND REVEGETATED.
- STOCKPILES SHALL BE OFF THE LIMITS OF THE LANDFILL GAP AND SURROUNDED ON THEIR PERIMETERS WITH STAKED HAY BALES AND/OR SILTATION FENCES TO PREVENT AND/OR CONTROL SILTATION AND EROSION AS REQUIRED.
- ALL DISTURBED OR EXPOSED AREAS SUBJECT TO EROSION SHALL BE STABILIZED AND SEEDED FOR TEMPORARY/PERMANENT VEGETATIVE COVER WHERE CONSTRUCTION ACTIVITIES HAVE PERMANENTLY CEASED IN ACCORDANCE WITH MASSACHUSETTS DEP EROSION AND SEDIMENT CONTROL GUIDELINES. NO OPEN EXCAVATIONS ARE TO BE LEFT OVERNIGHT WITHIN THE LIMITS OF THE LANDFILL COVER SYSTEM.
- ALL EROSION CONTROL MEASURES SHALL BE ROUTINELY INSPECTED IN ACCORDANCE WITH THE SWPPP AND THE MASS DEP POST-CLOSURE USE PERMIT.
- THE CONTRACTOR SHALL KEEP ON SITE AT ALL TIMES ADDITIONAL SILT FENCE AND HAY BALES FOR INSTALLATION AT THE DIRECTION OF THE ENGINEER AND/OR CONSERVATION COMMISSION AGENT TO MITIGATE ANY EMERGENCY CONDITION.
- THE AREA OF ENTRANCE AND EXIT TO AND FROM THE SITE SHALL BE MAINTAINED IN A CONDITION WHICH WILL PREVENT TRACKING OR FLOWING OF SEDIMENT ONTO PUBLIC RIGHT-OF-WAY. ALL SEDIMENT SPILLED, DROPPED, WASHED OR TRACKED ONTO PUBLIC RIGHT-OF-WAY MUST BE REMOVED IMMEDIATELY.
- UPON COMPLETION OF ALL SITE WORK CONSTRUCTION, THE SITE CONTRACTOR SHALL INSPECT ALL STORMWATER STRUCTURES AND SWALES AND REMOVE ALL SEDIMENT, TRASH AND DEBRIS THAT HAS ACCUMULATED.
- DUST CONTROL SHALL BE USED DURING EARTHWORK OPERATIONS AND SHALL CONSIST OF DAMPENING THE GROUND WITH WATER.
- EROSION CONTROL MEASURES SHOWN ON THE DRAWINGS DEPICT THE MINIMUM REQUIRED CONTROL, THE CONTRACTOR SHALL BE RESPONSIBLE FOR THE SITING, RELOCATION AND AUGMENTATION OF EROSION CONTROL DEVICES TO PROTECT WETLAND RESOURCES AS THE PROJECT PROGRESSES AND SITE DRAINAGE CONDITIONS CHANGE.
- THE CONTRACTOR SHALL, AT HIS EXPENSE, SURVEY AND MARK OUT IN THE FIELD THE LIMITS OF CLEARING AND EROSION CONTROL (I.E. SILT FENCE LINE) FOR APPROVAL PRIOR TO COMMENCEMENT OF CLEARING AND GRUBBING ACTIVITIES.
- PRIOR TO COMMENCEMENT OF CONSTRUCTION ACTIVITIES AT THE SITE, THE CONTRACTOR SHALL ENGAGE AN INDIVIDUAL WITH SPECIFIC TRAINING IN EROSION AND SEDIMENT CONTROL. THE EROSION CONTROL MONITOR SHALL PREPARE A WEEKLY REPORT WHICH SHALL BE KEPT ON SITE AT ALL TIMES AND SHALL BE SHOWN TO LOCAL, STATE AND FEDERAL AGENTS UPON REQUEST. THIS REPORT SHALL INDICATE THE STATUS OF THE EROSION CONTROLS AND ANY MAINTENANCE REQUIRED AND PERFORMED. THIS REPORT SHALL CONFORM TO THE REQUIREMENTS OF THE EPA'S NATIONAL POLLUTANT DISCHARGE ELIMINATION SYSTEM (NPDES) CONSTRUCTION GENERAL PERMIT.
- WOODEN STAKES SHALL NOT BE DRIVEN INTO GROUND WITHIN THE LIMIT OF THE LANDFILL COVER SYSTEM. SILT FENCE AND COMPOST FIBER ROLLS SHALL NOT BE USED FOR EROSION CONTROL WITHIN THE LIMIT OF THE LANDFILL COVER SYSTEM.

**SPECIFICATIONS**

- TOPSOIL:
- TOPSOIL SHALL BE FERTILE, NATURAL SOIL CAPABLE OF SUSTAINING VIGOROUS PLANT GROWTH, TYPICAL OF THE LOCALITY, FREE FROM STONES GREATER THAN 3 INCHES, ROOTS, STICKS, CLAY, PEAT, WEEDS AND SOD, AND SHALL BE OBTAINED FROM NATURALLY WELL DRAINED AREAS. IT SHALL NOT BE EXCESSIVELY ACIDIC OR ALKALINE NOR CONTAIN TOXIC MATERIAL HARMFUL TO PLANT GROWTH.
- GRASS SEED (FOR DISTURBED AREAS ONLY):
- GRASS SEED SHALL BE OF THE PREVIOUS YEAR'S CROP AND IN NO CASE SHALL THE WEED CONTENT EXCEED 1% BY WEIGHT. GRASS SEED SHALL BE CONSISTENT WITH TYPE M6.03.0 "FOR SLOPES AND SHOULDERS" OF THE MASSACHUSETTS HIGHWAY DEPARTMENT STANDARD SPECIFICATIONS FOR HIGHWAYS AND BRIDGES AND CONFORM TO THE REQUIREMENTS WITHIN THE TABLE BELOW.
  - A MANUFACTURER'S CERTIFICATE OF COMPLIANCE SHALL BE SUBMITTED WITH EACH SHIPMENT OF EACH TYPE OF SEED INDICATING THE GUARANTEED PERCENTAGE OR PURITY, WEED CONTENT AND GERMINATION OF THE SEED, AND THE NET WEIGHT AND DATE OF SHIPMENT.


GRASS SEED MIX			
MIXTURE	PROPORTION	GERMINATION MINIMUM	PURITY MINIMUM
CREEPING RED FESCUE	50%	85%	95%
KENTUCKY 31	30%	85%	95%
DOMESTIC RYE	10%	90%	98%
RED TOP	5%	85%	92%
LADINO CLOVER	5%	85%	96%

**TREE CLEARING**

- 50% MAXIMUM TREE CLEARING IN WETLANDS BUFFER AREAS PER THE TOWN OF DOVER WETLANDS BY LAWS.
- TREE CUTTING TO BE COORDINATED WITH THE TOWN OF DOVER CONSERVATION COMMISSION.

TREE CLEARING NOTE ADDED TO PLAN SET

DETAIL ADDED TO PLAN SET

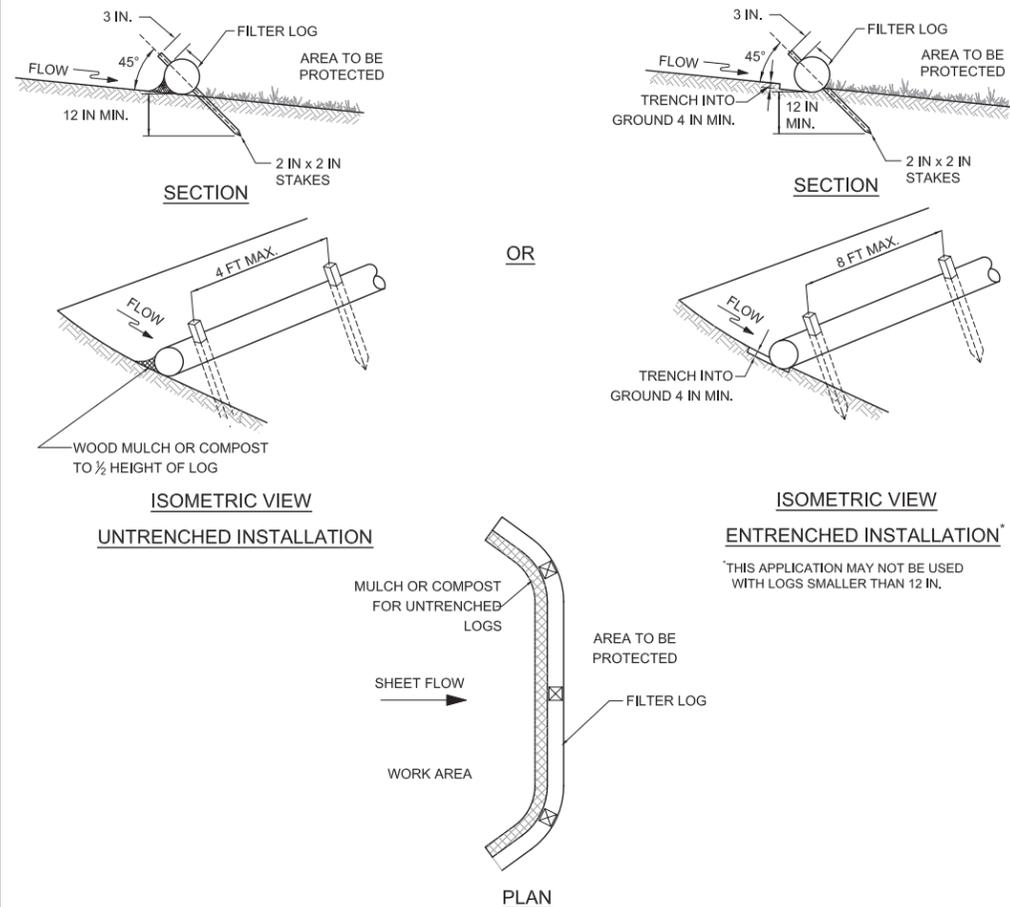


**STAKE-DRIVEN FILTER LOG DETAIL A**

NOT TO SCALE C6

**CONSTRUCTION SPECIFICATIONS:**

- PRIOR TO INSTALLATION, CLEAR ALL OBSTRUCTIONS INCLUDING ROCKS, CLODS, AND DEBRIS GREATER THAN ONE INCH THAT MAY INTERFERE WITH PROPER FUNCTION OF FILTER LOG.
- FILL LOG NETTING UNIFORMLY WITH COMPOST (IN ACCORDANCE WITH SECTION H-1 MATERIALS), OR OTHER APPROVED BIODEGRADABLE MATERIAL TO DESIRED LENGTH SUCH THAT LOGS DO NOT DEFORM.
- INSTALL FILTER LOGS PERPENDICULAR TO THE FLOW DIRECTION AND PARALLEL TO THE SLOPE WITH THE BEGINNING AND END OF THE INSTALLATION POINTING SLIGHTLY UP THE SLOPE CREATING A "J" SHAPE AT EACH END TO PREVENT BYPASS.
- FOR UNTRENCHED INSTALLATION BLOW OR HAND PLACE MULCH OR COMPOST ON UPHILL SIDE OF THE SLOPE ALONG LOG.
- STAKE FILTER LOG EVERY 4 FEET OR CLOSER ALONG ENTIRE LENGTH OF LOG OR TRENCH LOG INTO GROUND A MINIMUM OF 4 INCHES AND STAKE LOG EVERY 8 FEET OR CLOSER.
- USE STAKES WITH A MINIMUM NOMINAL CROSS SECTION OF 2X2 INCH AND OF SUFFICIENT LENGTH TO ATTAIN A MINIMUM OF 12 INCHES INTO THE GROUND AND 3 INCHES PROTRUDING ABOVE LOG.
- WHEN MORE THAN ONE LOG IS NEEDED, OVERLAP ENDS 12 INCHES MINIMUM AND STAKE.
- REMOVE SEDIMENT WHEN IT HAS ACCUMULATED TO A DEPTH OF 1/2 THE EXPOSED HEIGHT OF LOG AND REPLACE MULCH. REPLACE LOG IF TORN, REINSTALL FILTER LOG IF UNDERMINING OR DISLODGING OCCURS, REPLACE CLOGGED FILTER LOGS. FOR PERMANENT APPLICATIONS, ESTABLISH AND CONTINUOUSLY MEET REQUIREMENTS FOR ADEQUATE VEGETATIVE ESTABLISHMENT IN ACCORDANCE WITH SECTION B-4 VEGETATIVE STABILIZATION.

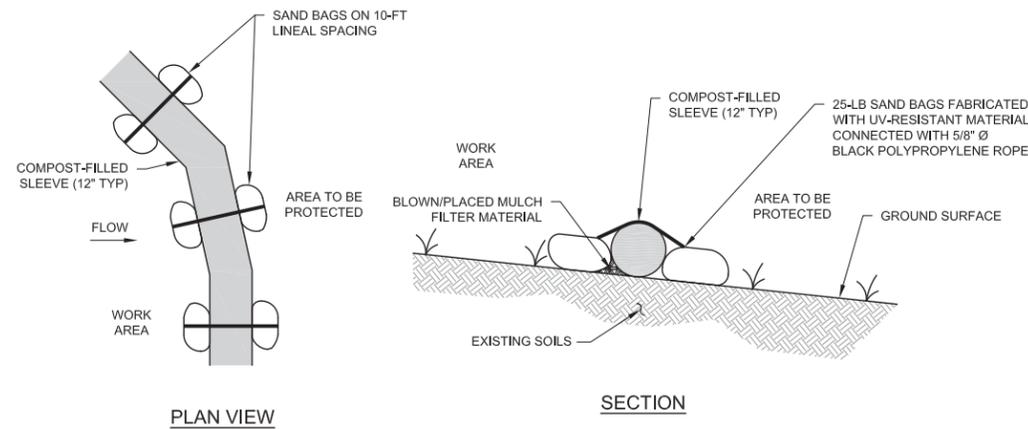

**FILTER LOG EROSION CONTROL DETAIL B**

NOT TO SCALE C6

- NOTE:
- TUBULAR SEDIMENT CONTROL SHALL BE FILTREXX SILTSOXX OR EQUIVALENT APPROVED BY ENGINEER

NOTICE

THIS EQUIPMENT IS OWNED AND OPERATED BY:  
**BWC BUCKMASTER POND, LLC**  
 IN CASE OF EMERGENCY CALL 911 AND (401) 640-6527

TO BE INSTALLED ON FENCE ADJACENT TO GATE

EMERGENCY CONTACT SIGNAGE C

NOT TO SCALE C6


FOR PERMITTING ONLY

**Kennedy/Jenks Consultants**  
TEWKSBURY, MA

USE OF DOCUMENTS:  
THIS DOCUMENT, INCLUDING THE INCORPORATED DESIGNS, IS AN INSTRUMENT OF SERVICE FOR THIS PROJECT AND SHALL NOT BE USED FOR ANY OTHER PROJECT WITHOUT THE WRITTEN AUTHORIZATION OF KENNEDY/JENKS CONSULTANTS.

NO.	REVISION	DATE	BY
1	ISSUED FOR PERMITTING	23 JUN 2016	BRK

**SCALES**  
0 1"  
0 25mm  
IF THIS BAR IS NOT DIMENSION SHOWN, ADJUST SCALES ACCORDINGLY.

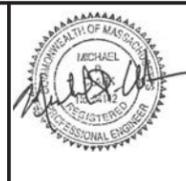

DESIGNED: J. SMITH  
DRAWN: B. KIELY  
CHECKED: M. CLARK

**DETAILS SHEET 3**

BWC BUCKMASTER POND, LLC  
BOSTON, MA

**DOVER LANDFILL SOLAR DEVELOPMENT PROJECT**

FILE NAME: 1642009\_CIVIL\_Details  
JOB NO.: 1642009\*00  
DATE: 20 JULY 2016  
SHEET OF: **C6** OF 8

JONATHAN SMITH 7/25/2016 2:50 PM P:\2016\1642009.00 - BWC Buckmaster Pond, LLC Dover Landfill\CAD\Design\1642009\_CIVIL\_Details.dwg



### LEGEND

- WETLANDS FLAG
- WETLANDS SYMBOL
- WETLANDS BOUNDARY
- 50' WETLANDS BUFFER
- 100' WETLANDS BUFFER
- LIMIT OF LANDFILL CAP
- PROPERTY BOUNDARY
- STONE WALL
- MAJOR ELEVATION CONTOUR (10' INTERVALS)
- MINOR ELEVATION CONTOUR (2' INTERVALS)
- EXISTING CHAIN LINK FENCE
- TREE LINE
- EXISTING UNDERGROUND GAS LINE
- EDGE OF PAVEMENT
- INVERT ELEVATION
- CORRUGATED METAL PIPE
- MONITORING WELL LOCATION
- GAS PROBE LOCATION
- PROPOSED INFORMATIONAL KIOSK LOCATION

EOP  
INV  
CMP  
MW-2  
G-2

**TYPHO CORRECTED**

#### FILTER LOGS

ID	LENGTH (LF)
FL-1	432.9
FL-2	426.5
<b>TOTAL</b>	<b>859.4</b>

#### NON PENETRATING FILTER LOGS

ID	LENGTH (LF)
NPFL-1	275.0
NPFL-2	119.5
NPFL-3	80.8
NPFL-4	37.1
NPFL-5	71.4
NPFL-6	197.3
NPFL-7	142.8
NPFL-8	100.5
NPFL-9	87.7
NPFL-10	67.7
NPFL-11	36.9
NPFL-12	231.3
NPFL-13	612.2
<b>TOTAL</b>	<b>2060.2</b>

JONATHAN SMITH 7/25/2016 2:19 PM  
 P:\2016\1642009.00 - BWC Buckmaster Pond, LLC Dover Landfill\CAD\Design\1642009\_CIVIL\_ESC.dwg

**Kennedy/Jenks Consultants.**  
TEWKSBURY, MA


USE OF DOCUMENTS:  
THIS DOCUMENT, INCLUDING THE INCORPORATED DESIGNS, IS AN INSTRUMENT OF SERVICE FOR THIS PROJECT AND SHALL NOT BE USED FOR ANY OTHER PROJECT WITHOUT THE WRITTEN AUTHORIZATION OF KENNEDY/JENKS CONSULTANTS.

NO.	REVISION	DATE	BY
1	ISSUED FOR PERMITTING	23 JUN 2016	BRK

**SCALES**

0 — 1"  
0 — 25mm

IF THIS BAR IS NOT DIMENSION SHOWN, ADJUST SCALES ACCORDINGLY.

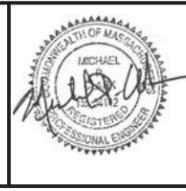

DESIGNED	J. SMITH
DRAWN	B. KIELY
CHECKED	M. CLARK


**EROSION AND SEDIMENT CONTROL PLAN**

BWC BUCKMASTER POND, LLC  
BOSTON, MA

**DOVER LANDFILL  
SOLAR DEVELOPMENT PROJECT**

FILE NAME	1642009_CIVIL_ESC
JOB NO.	1642009*00
DATE	20 JULY 2016
SHEET	OF
<b>C7</b>	

**FOR PERMITTING ONLY**

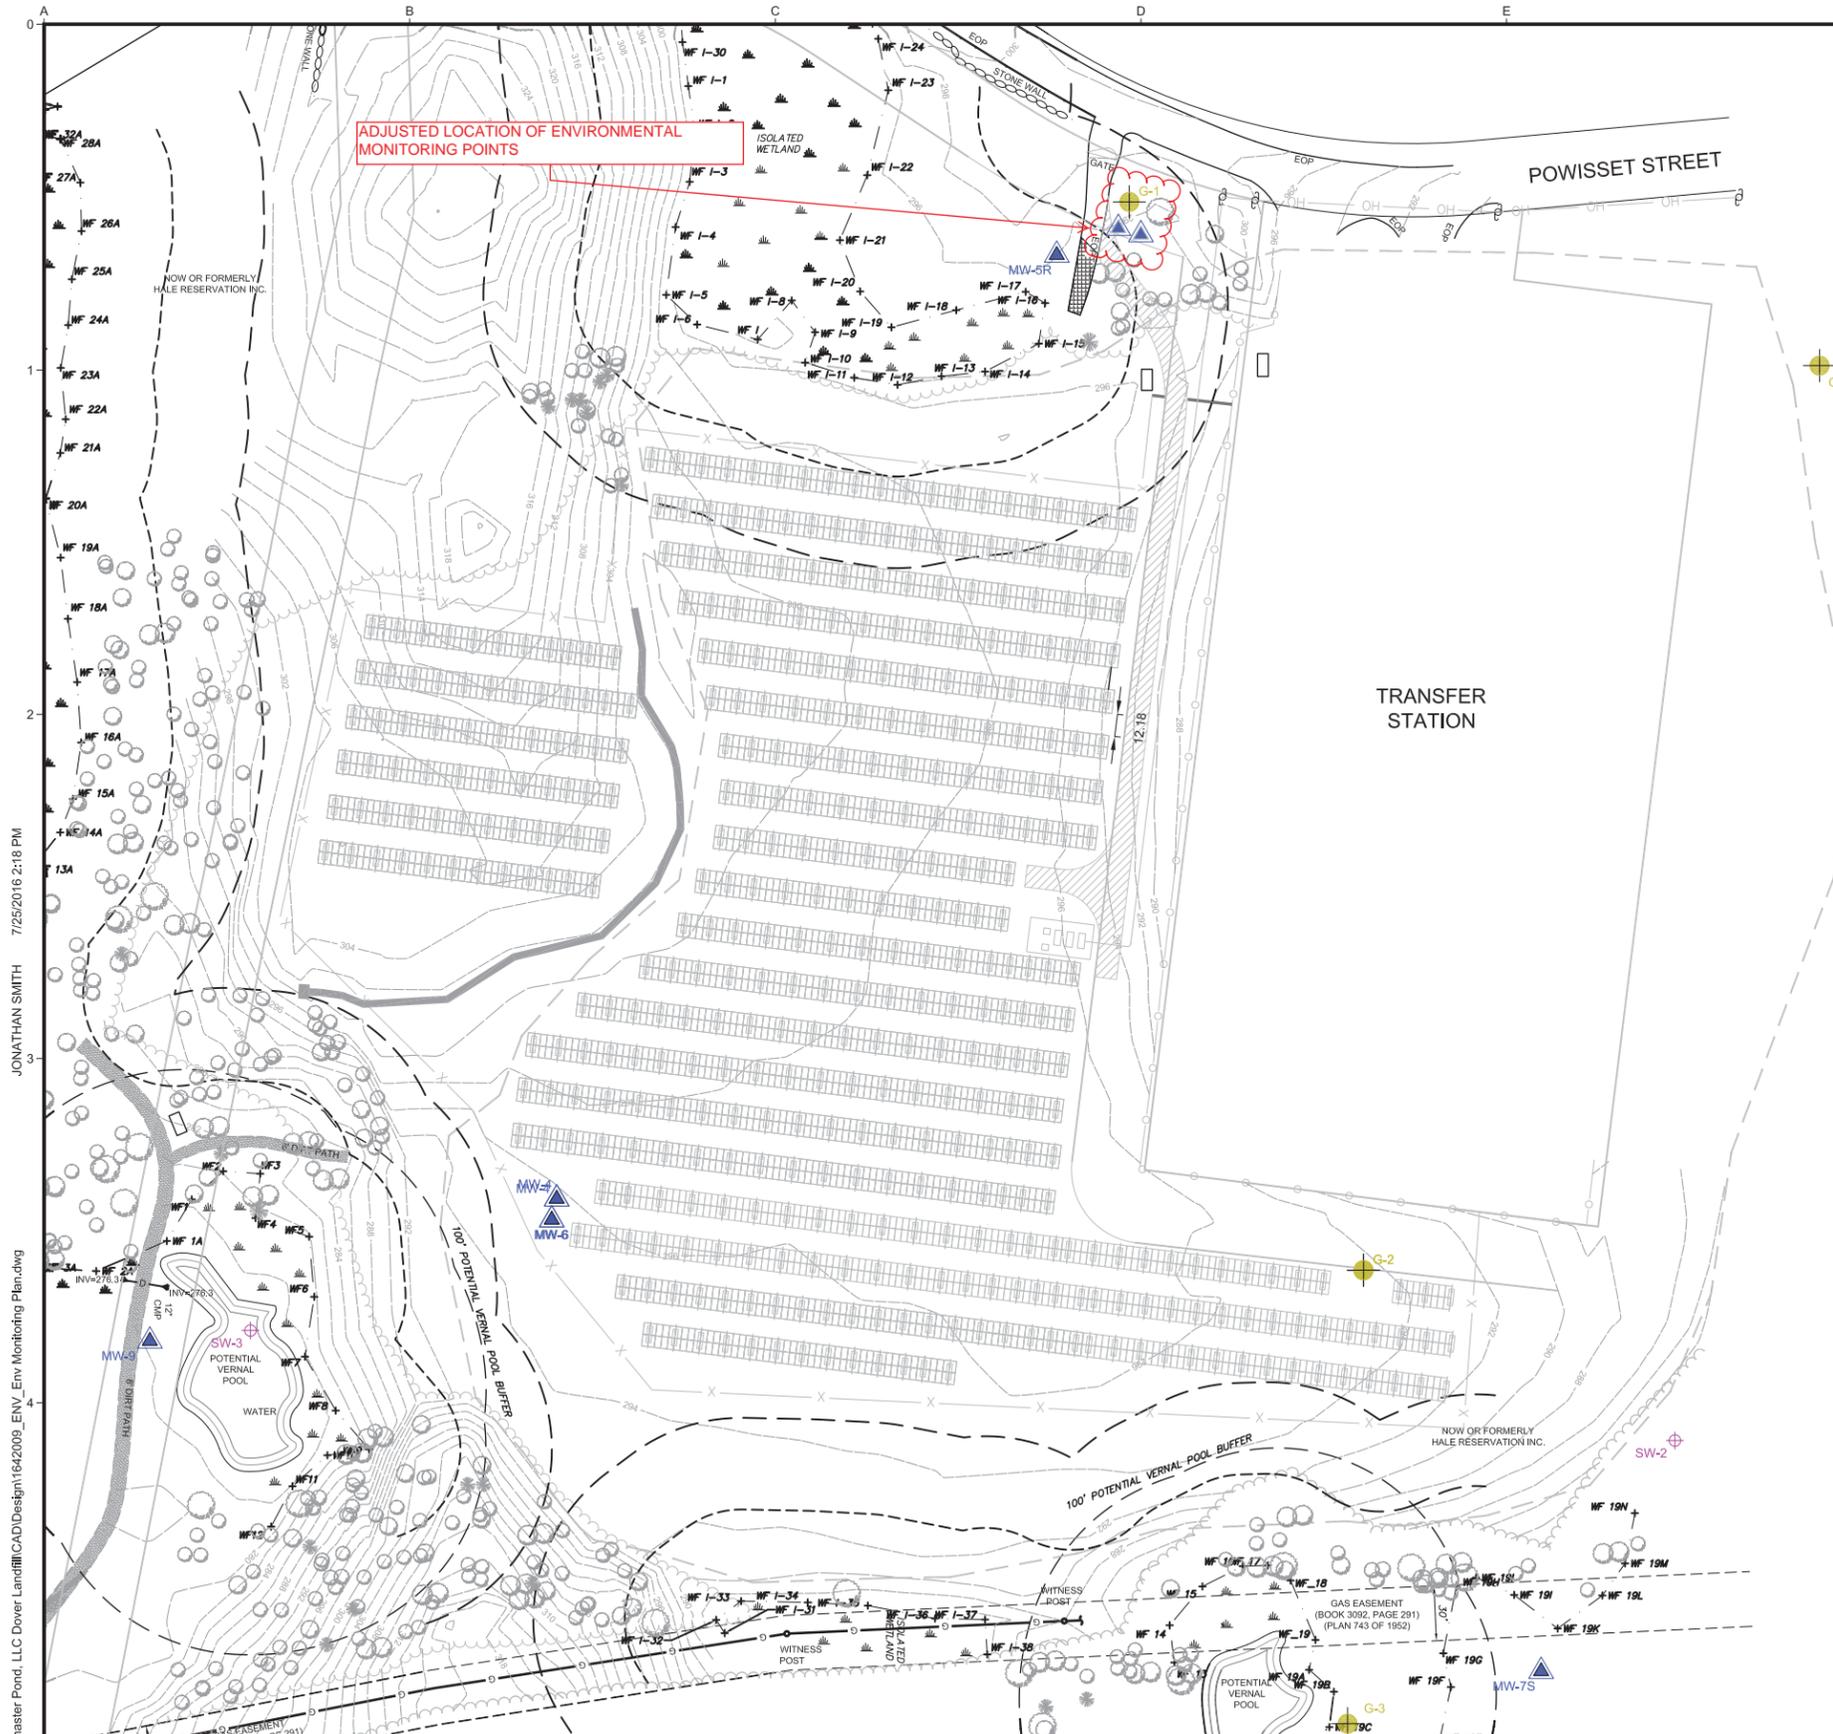

**LEGEND**


- WF 1-20 WETLANDS FLAG
  - WETLANDS SYMBOL
  - WETLANDS BOUNDARY
  - 50' WETLANDS BUFFER
  - 100' WETLANDS BUFFER
  - LIMIT OF LANDFILL CAP
  - PROPERTY BOUNDARY
  - STONE WALL
  - MAJOR ELEVATION CONTOUR (10' INTERVALS)
  - MINOR ELEVATION CONTOUR (2' INTERVALS)
  - EXISTING CHAIN LINK FENCE
  - TREE LINE
  - EXISTING UNDERGROUND GAS LINE
  - EOP EDGE OF PAVEMENT
  - INV INVERT ELEVATION
  - CMP CORRUGATED METAL PIPE
  - PROPOSED INFORMATIONAL KIOSK LOCATION
- TYPO CORRECTED

**NOTES**

THE PURPOSE OF THIS PLAN IS TO DEPICT THE LOCATIONS OF EXISTING ENVIRONMENTAL SAMPLING POINTS PRESENT AT THE SITE. NO ADDITIONAL MONITORING LOCATIONS ARE PROPOSED FOR THIS PROJECT.

**ENVIRONMENTAL MONITORING LEGEND**

- MW-2 MONITORING WELL LOCATION
- SW-2 SURFACE WATER MONITORING LOCATION
- G-2 GAS PROBE LOCATION

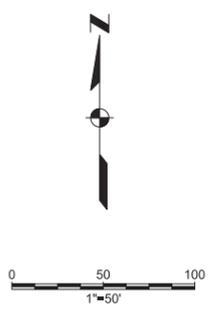

P:\2016\1642009.00 - BWC Buckmaster Pond, LLC Dover Landfill\CAD\Design\1642009\_ENV\_Env\_Monitoring\_Plan.dwg  
 JONATHAN SMITH 7/25/2016 2:18 PM

**Kennedy/Jenks Consultants.**  
 TEWKSBURY, MA


USE OF DOCUMENTS:  
 THIS DOCUMENT, INCLUDING THE INCORPORATED DESIGNS, IS AN INSTRUMENT OF SERVICE FOR THIS PROJECT AND SHALL NOT BE USED FOR ANY OTHER PROJECT WITHOUT THE WRITTEN AUTHORIZATION OF KENNEDY/JENKS CONSULTANTS.

NO.	REVISION	DATE	BY
1	ISSUED FOR PERMITTING	23 JUN 2016	BRK

DESIGNED	J. SMITH
DRAWN	B. KIELY
CHECKED	M. CLARK

**SCALES**  
 0 1"  
 0 25mm

IF THIS BAR IS NOT DIMENSION SHOWN, ADJUST SCALES ACCORDINGLY.

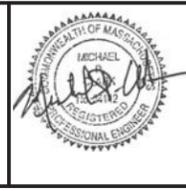

**FOR PERMITTING ONLY**

<b>ENVIRONMENTAL MONITORING PLAN</b>		FILE NAME 1642010_ENV
BWC BUCKMASTER POND, LLC BOSTON, MA		JOB NO. 1642009'00
<b>DOVER LANDFILL SOLAR DEVELOPMENT PROJECT</b>		DATE 20 JULY 2016
		SHEET OF <b>C8</b> 8